


PLAN 2

Kontor 585 kvm

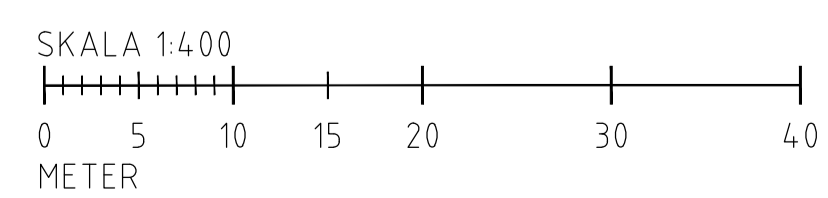

| |
|--|
| |
|--|

| BET | ANT | ÄNDRINGEN AVSER | SIGN | DATUM |
|----------------------|-----------|-----------------|------|-------|
| RELATIONSHANDLING | | | | |
| TAGENEVÄGEN 21 | | | | |
| | | | | |
| | | | | |
| KARRA 37:4, GÖTEBORG | | | | |
| PLAN 2 | | | | |
| SKALA | 1:400(A1) | NU | | |
| | 1:800(A3) | | | |