


Lager 432 kvm

Lager 1604 kvm

PLAN 1

Total lageryta 2036 kvm

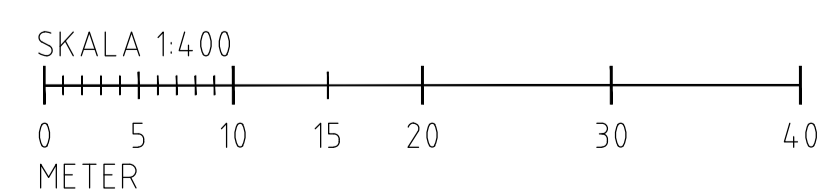

BET	ANT	ÄNDRINGEN AVSER	SIGN	DATUM
RELATIONSHANDLING				
TAGENEVÄGEN 21				
PLAN 1				
SKALA	1:400(A1)	NU		T
	1:800(A3)			